



rick+cindyblack
ARCHITECTS
4707 Shoalwood Avenue
Austin, Texas 78756
512-402-3152 [voice]
info@rickandcindy.net

NOT INTENDED
FOR BIDDING,
PERMITTING, OR
CONSTRUCTION


FOR REVIEW
DEC. 15, 2025

RESIDENCE AT
1934 N. Walnut Springs Rd
Johnson City, TX 76636

PHASE 2
DESIGN


AS-BUILT
FLOOR PLAN

A1.0

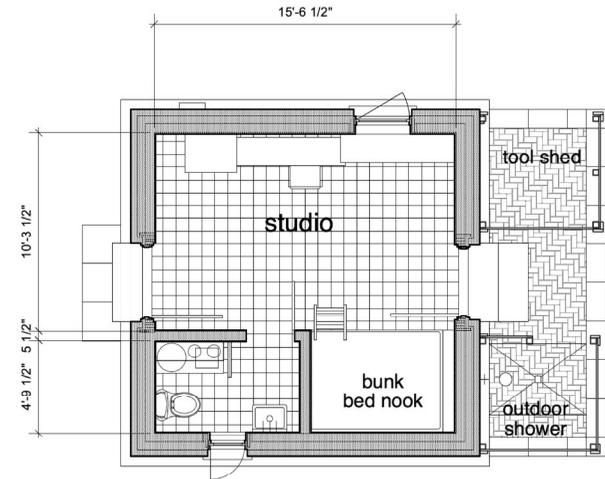

2 FLOOR PLAN - STUDIO - 324 SF

A1.0 SCALE: 1/4" = 1'-0"

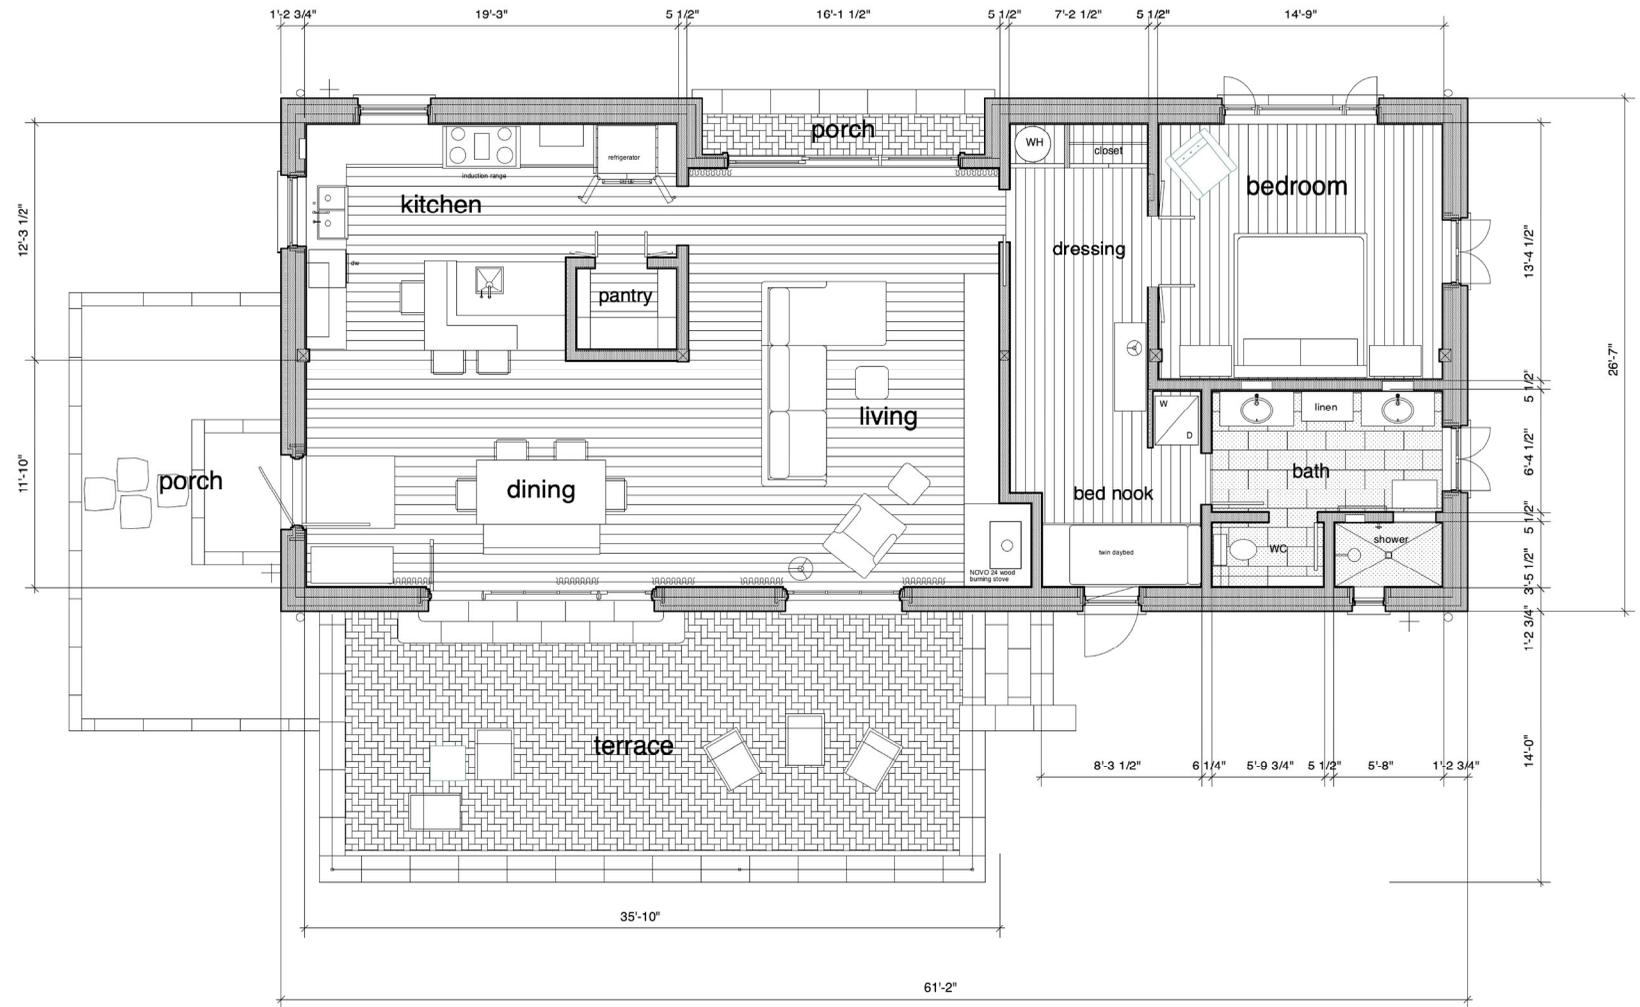

1 FLOOR PLAN - MAIN HOUSE - 1584 SF

A1.0 SCALE: 1/4" = 1'-0"

